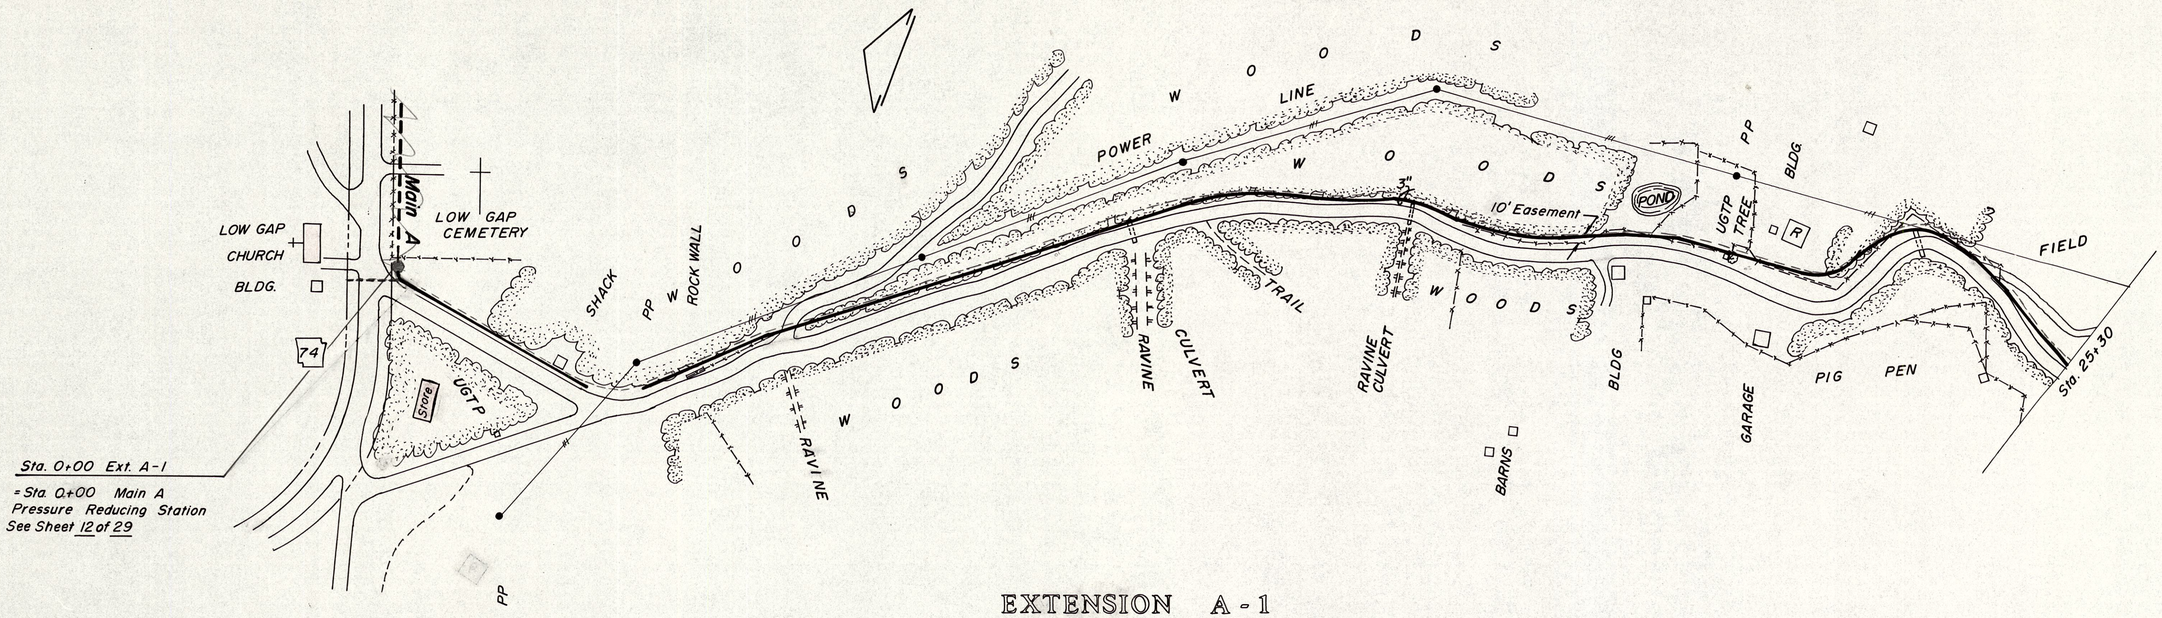

EXTENSION A-1

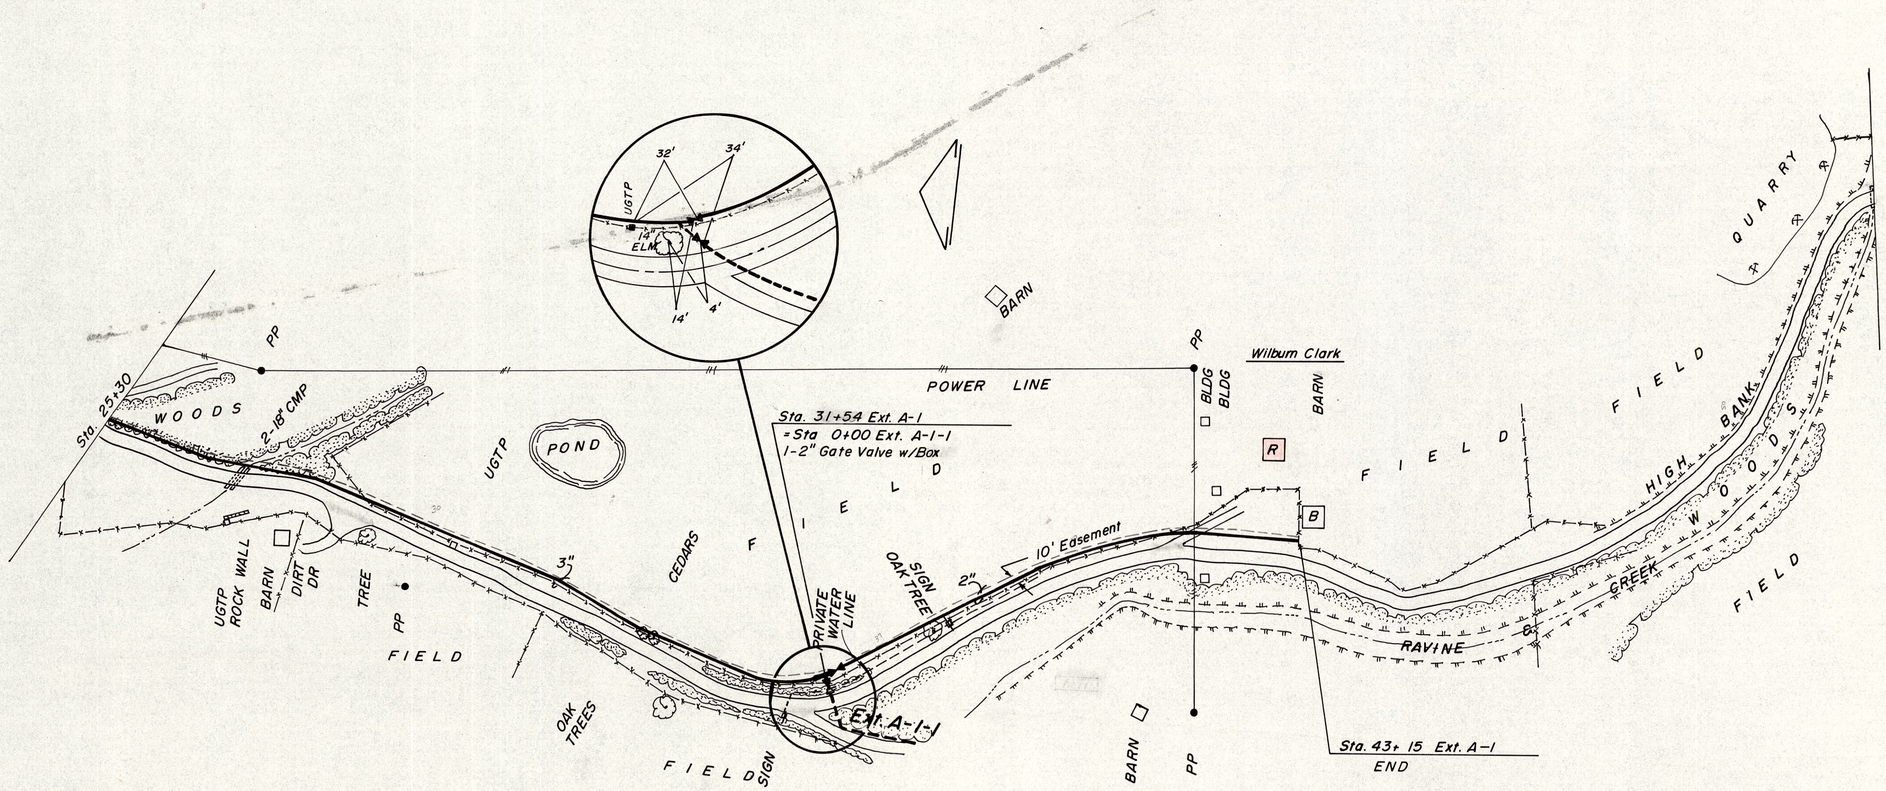

EXTENSION A-1

RECORD DRAWING
DATE Jan. 9, 1984

DATE	REVISIONS

SURVEY BY:
DESIGN BY:
DRAWN BY:
CHECKED BY:

MT. SHERMAN WATER ASSOCIATION
NEWTON COUNTY, ARKANSAS
EXTENSION A-1

BLAYLOCK, THREET & ASSOCIATES, INC.
Consulting Engineers
MECHANICAL-ELECTRICAL
CIVIL-SURVEYING
1501 MARKET DRIVE
LITTLE ROCK, ARKANSAS

STATE OF ARKANSAS
REGISTERED PROFESSIONAL ENGINEER

SCALE 1" = 100'
DATE APR. 1982
PROJECT NO. 80 055 2
SHEET 10 OF 29

BRUNING 4D-105 49548